

Table 1: Reordering of the Drawings

Original Specification	Substitute Specification
<u>Drawing Number</u>	<u>Drawing Number</u>
FIG. 10	FIG. 9
FIG. 9	FIG. 10

Accordingly, the specification section entitled, “BRIEF DESCRIPTION OF THE DRAWINGS” has been revised to reflect the reordering of the drawings.

Furthermore, Applicants have added section headings to the specification section entitled, “DETAILED DESCRIPTION OF THE PREFERRED EMBODIMENTS” to facilitate easier reading of the specification.

A description of step 136 (original drawing reference number 108 of FIG. 7) and step 138 (original drawing reference number 107 of FIG. 7) is added to the specification, as shown at page 22 of the marked-up copy of the specification. Because the added description to the specification merely describes matter originally disclosed in FIG. 7, the Applicants respectfully submit that the added description of steps 136 and 138 does not constitute new matter.

A description of FIG. 9 (originally drawing FIG. 10 in the original application) is added to the specification, as shown at page 24 of the marked-up copy of the specification. Included in a description that includes step 360 (original drawing reference number 700 of original FIG. 10), step 362 (original drawing reference number 701 of original FIG. 10), step 364 (original drawing reference number 702 of original FIG. 10), step 366 (original drawing reference number 703 of original FIG. 10), step 368 (original drawing reference number 704 of original FIG. 10) and step 370 (original drawing reference number 705 of original FIG. 10). Because the added description to the specification merely describes matter originally disclosed in original FIG. 10 (now amended to be FIG. 9), the Applicants respectfully submit that the added description of FIG. 9 consisting of steps 360-370 does not constitute new matter.

Clarification to the specification is made for FIG. 13B, as shown at pages 47-48 of the marked-up copy of the specification. Because the above-described revisions to the specification clarify the discussion of FIG. 13B, the Applicants respectfully submit that the revision does not constitute new matter.

Other amendments to the specification correct minor typographical errors or clarify the specification for the convenience of the reader. Also, drawing numbers [e.g.: "RAM 413 (FIG. 10)" at page 39 of the marked-up substitute specification] have been added throughout the specification to help the reader locate the drawing to which a particular reference number applies. The Applicants respectfully submit that these revision do not constitute new matter.


CONCLUSION

It is believed that the foregoing amendments add no new matter to the present application. Accordingly, Applicants respectfully request that the present amendment and substitute specification be entered under 37 C.F.R. §1.312(a).

Respectfully Submitted,

**THOMAS, KAYDEN, HORSTEMEYER &
RISLEY, L.L.P.**

By:

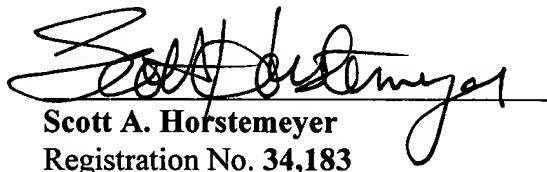
Scott A. Horstemeyer
Registration No. 34,183

100 Galleria Parkway, Suite 1750
Atlanta, Georgia 30339-5948
(770) 933-9500

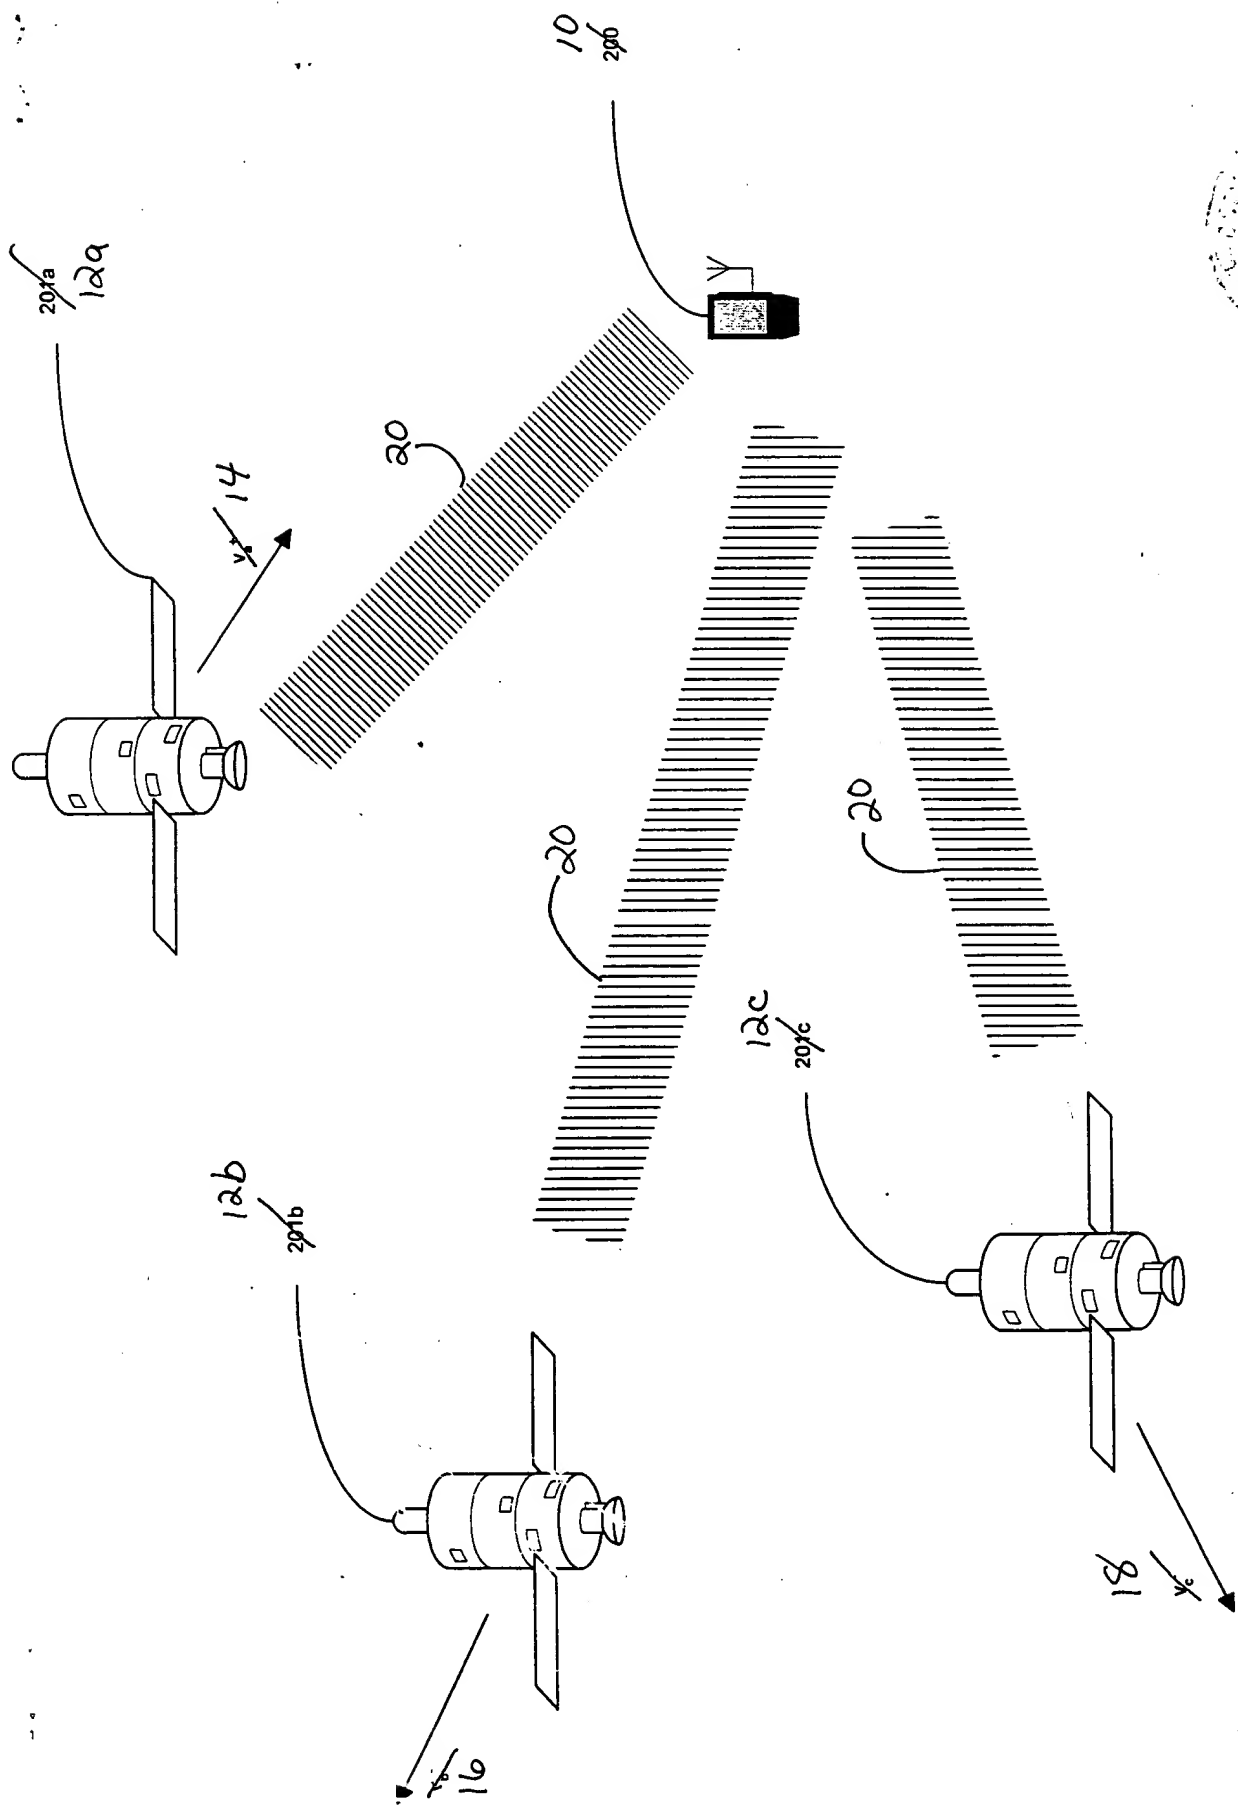
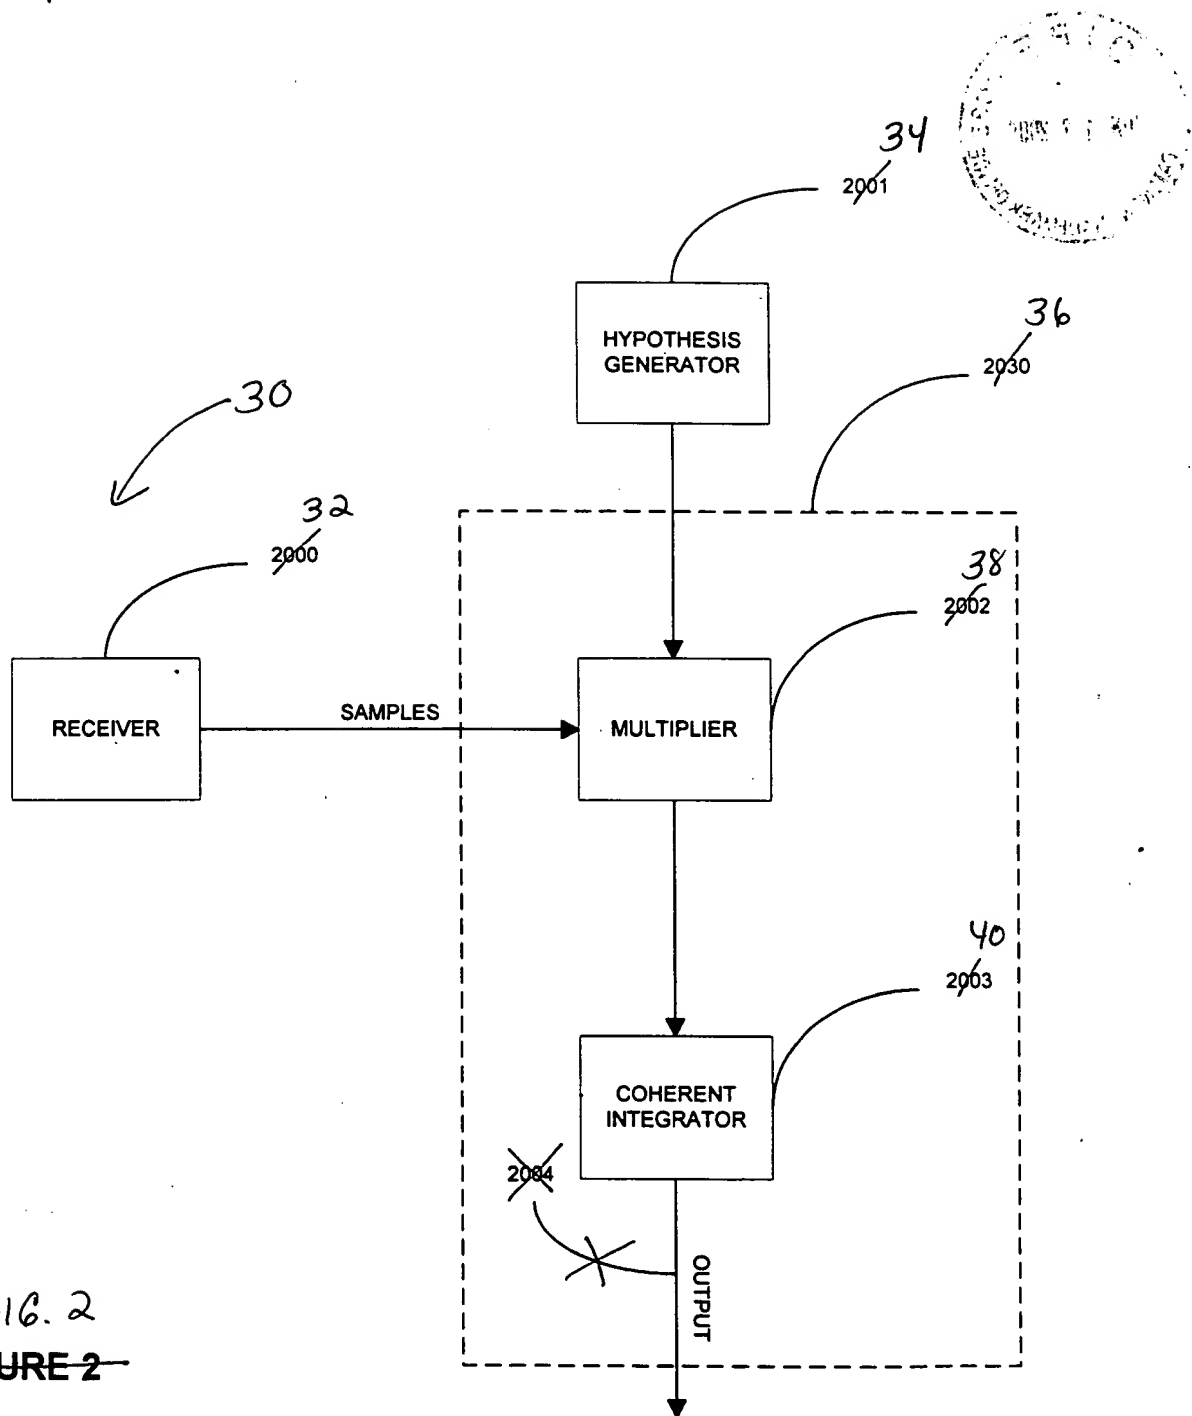


FIG. 1
—FIGURE 1—



FIG. 2
~~FIGURE 2~~



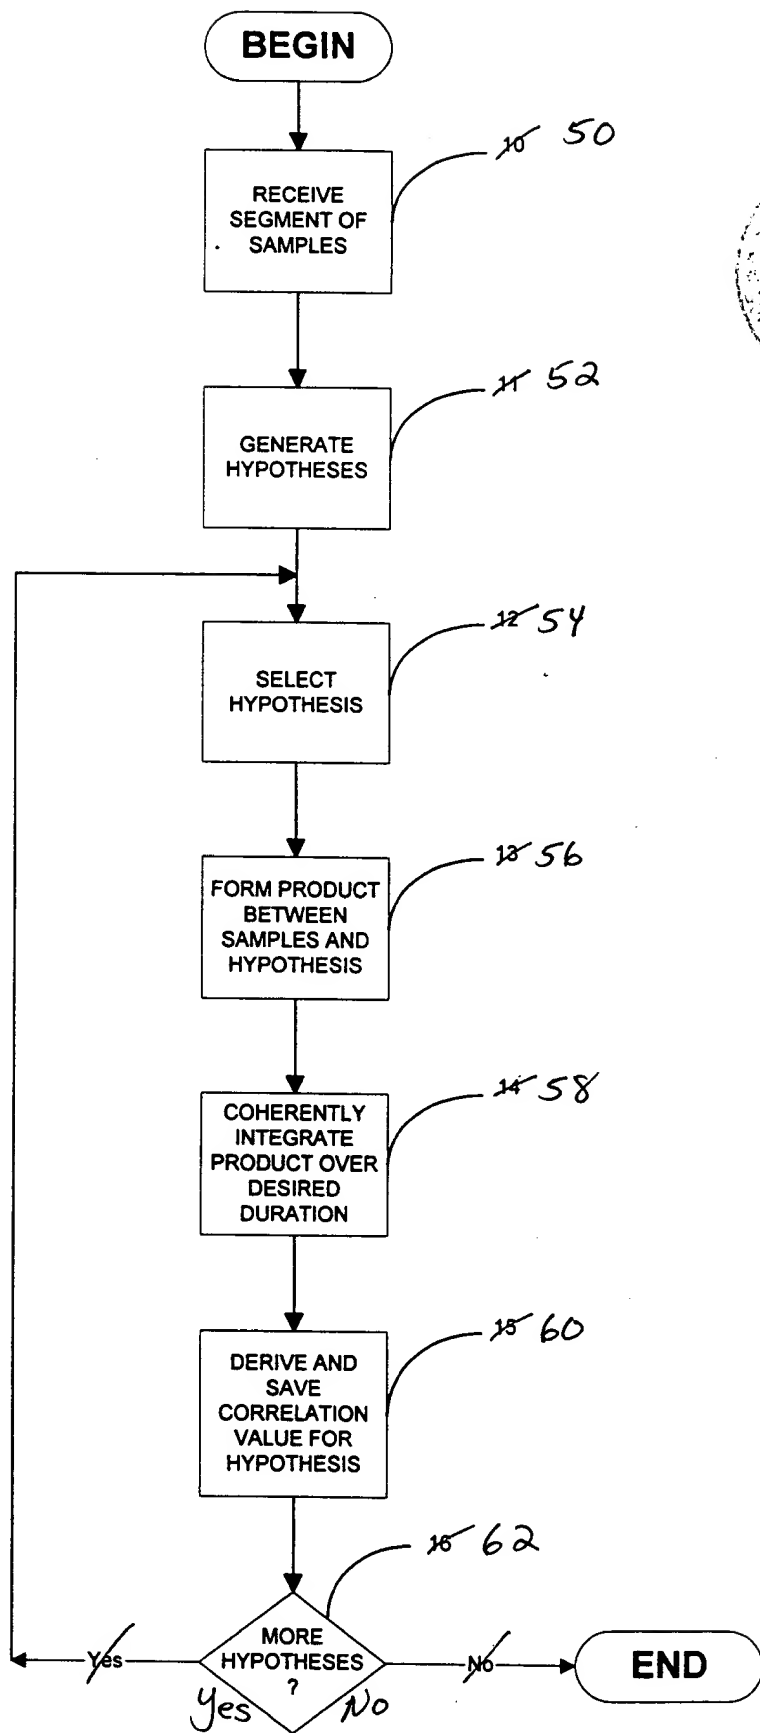


FIG. 3
~~FIGURE 3~~

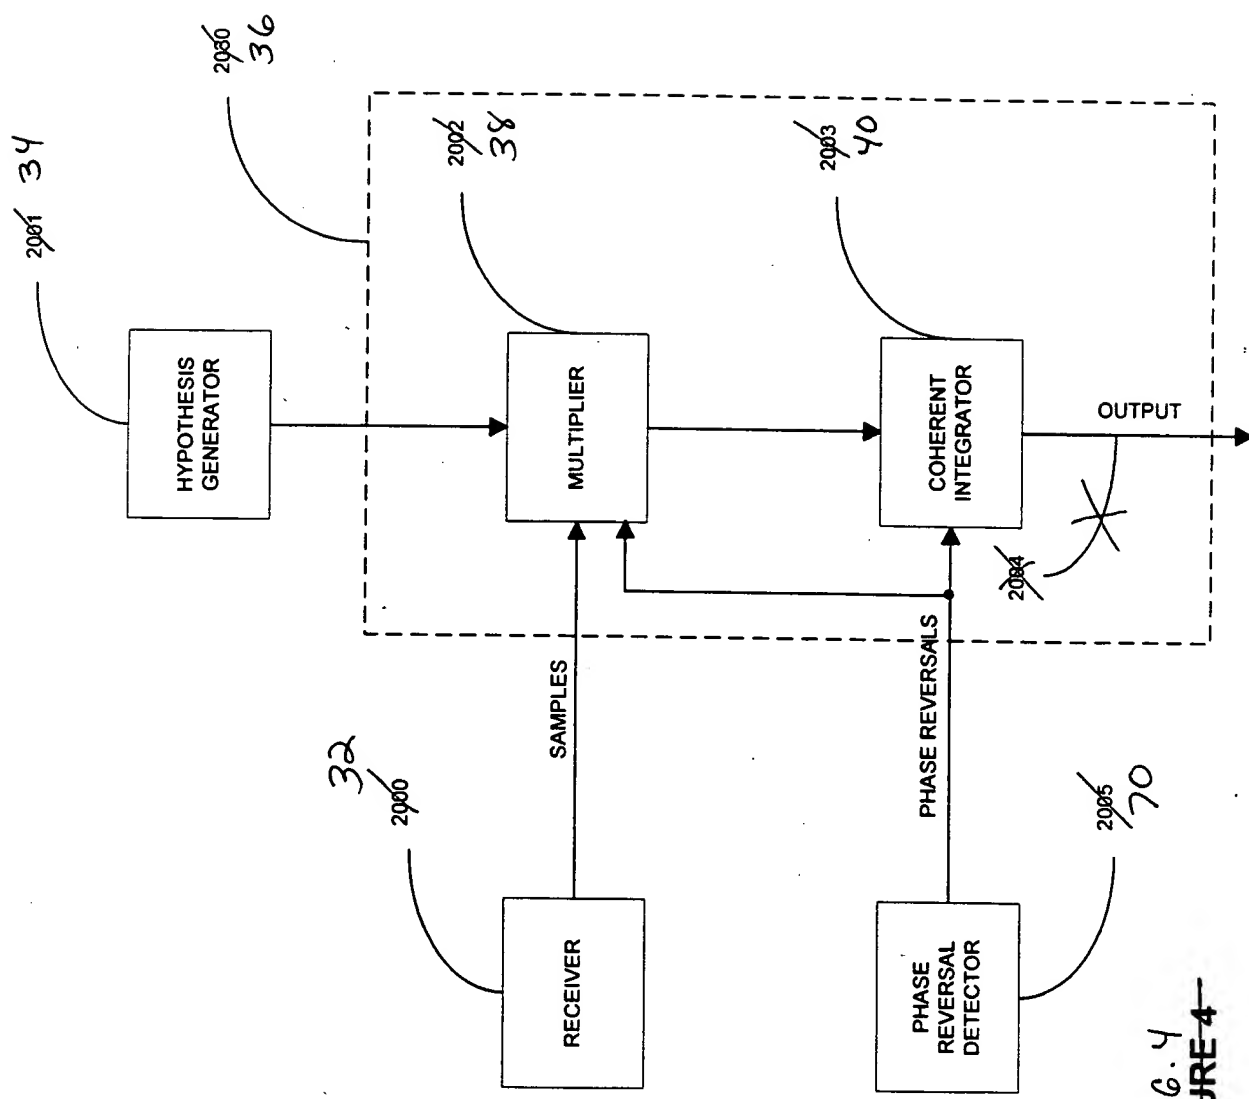
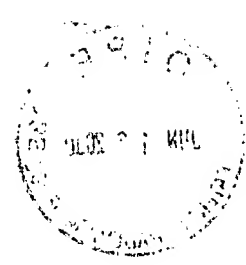


FIG. 4
FIGURE 4

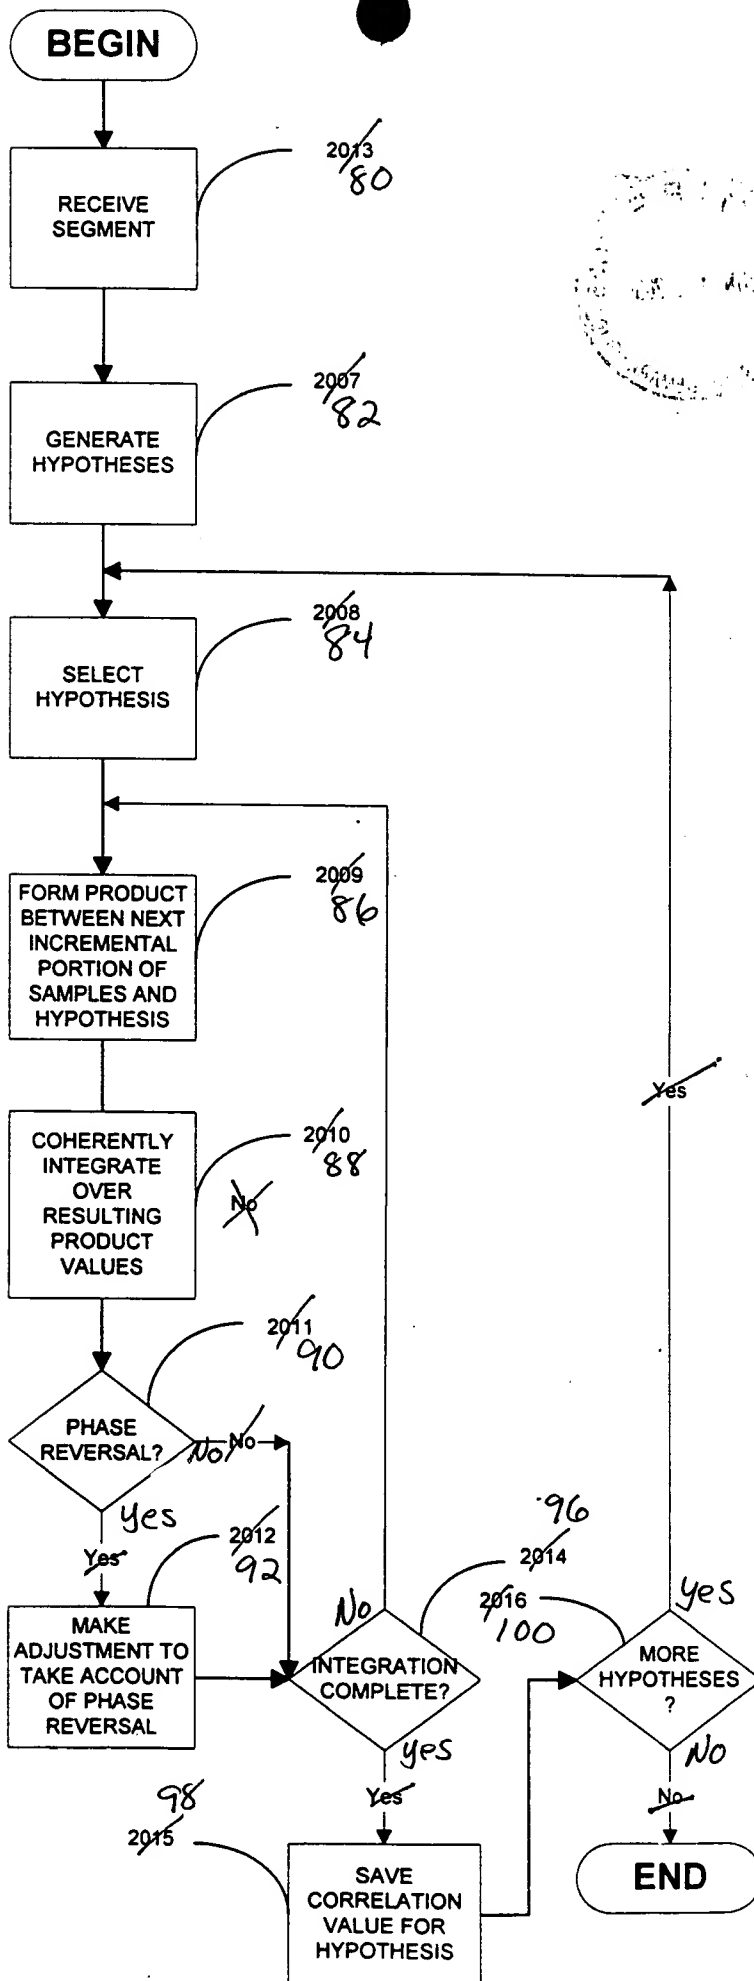


FIG. 5
FIGURE 5

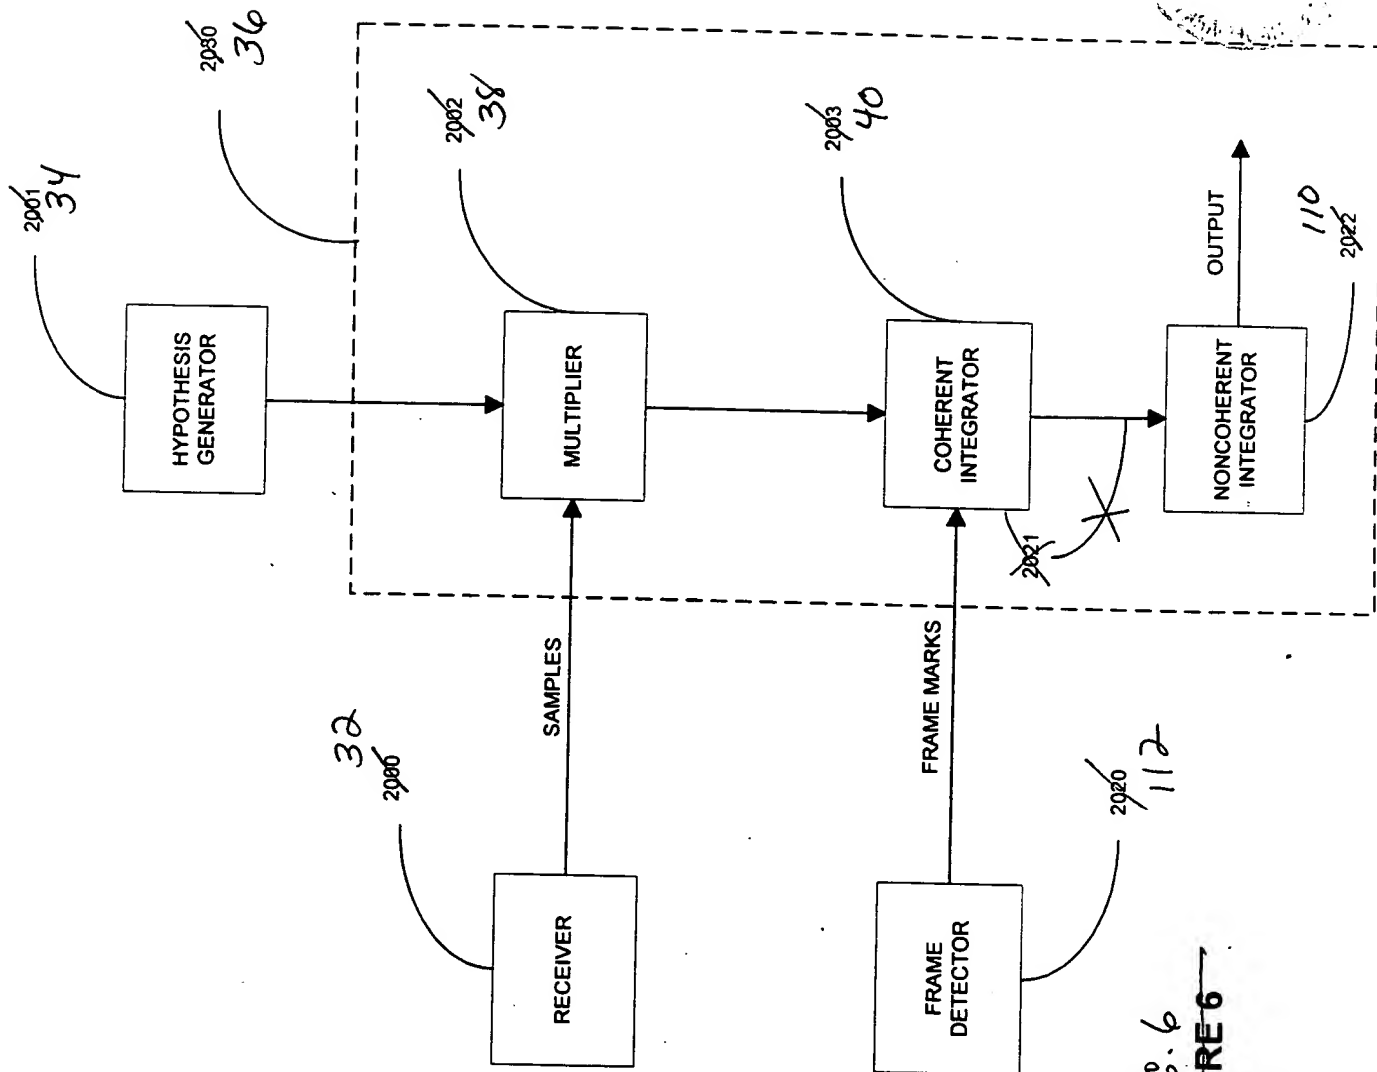


FIG. 6
FIGURE 6

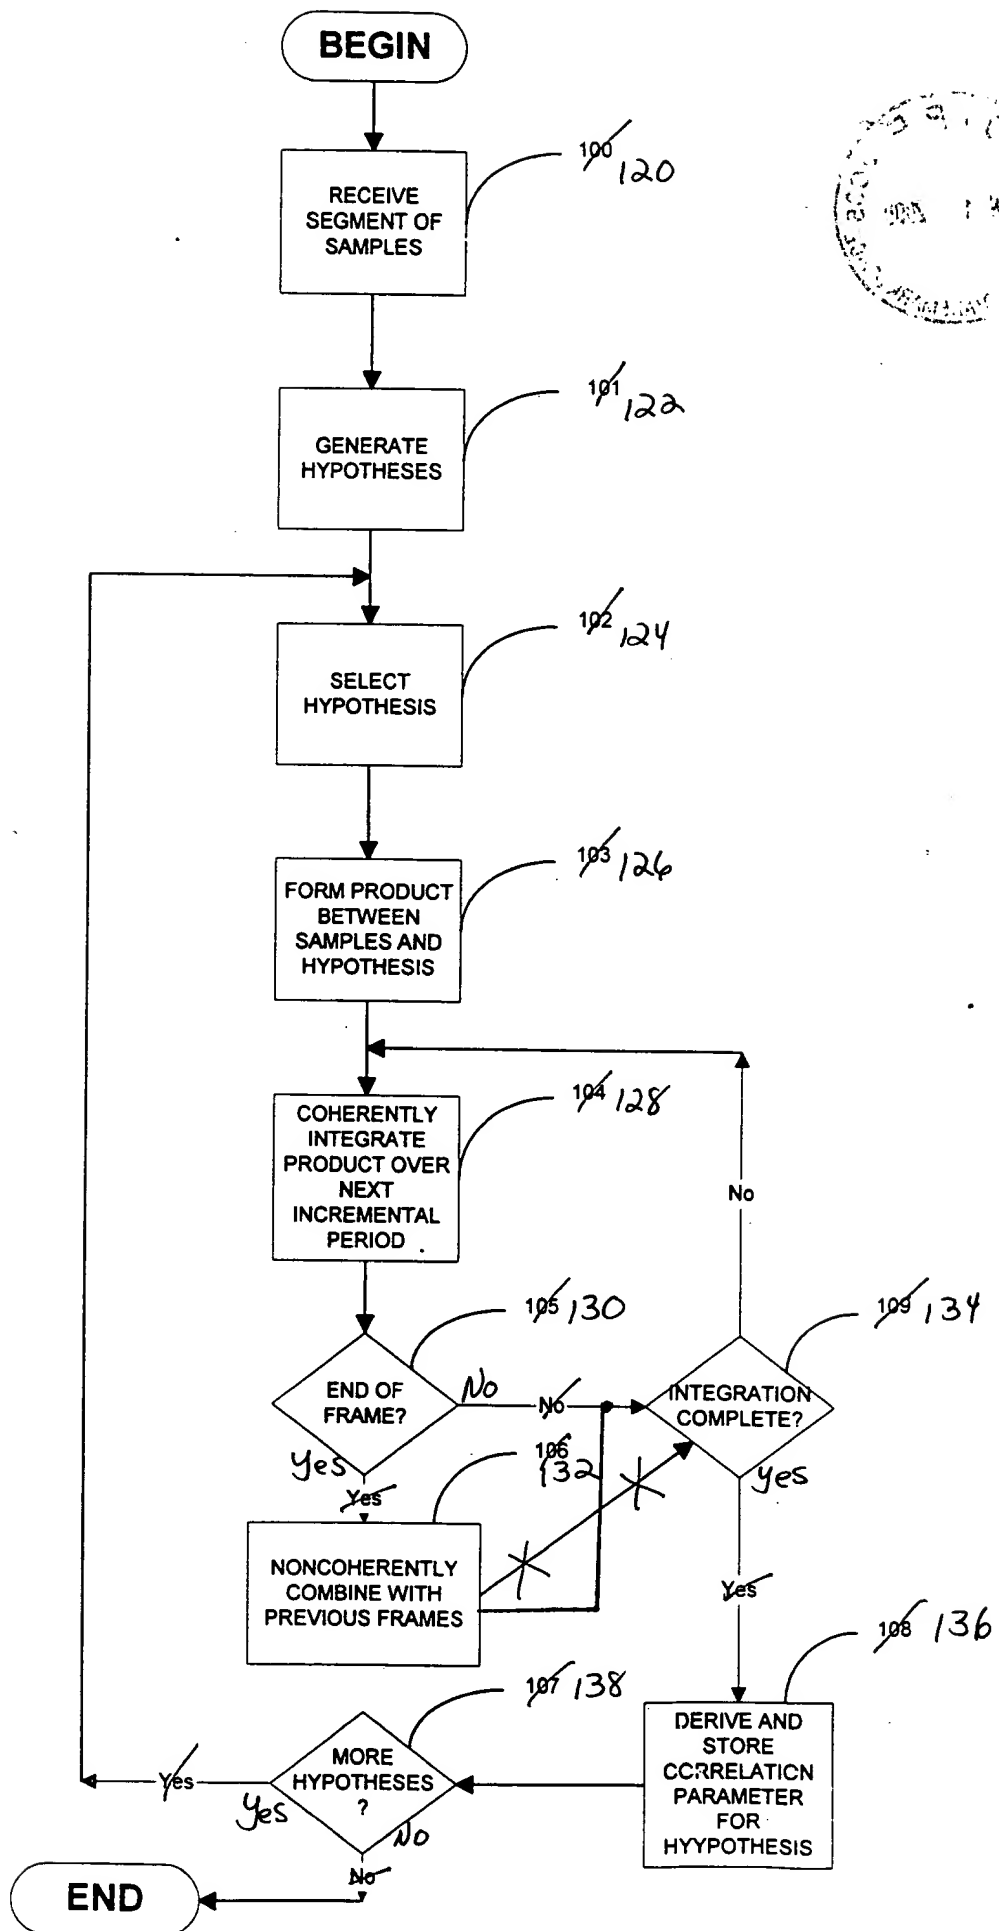


FIG. 7
FIGURE 7

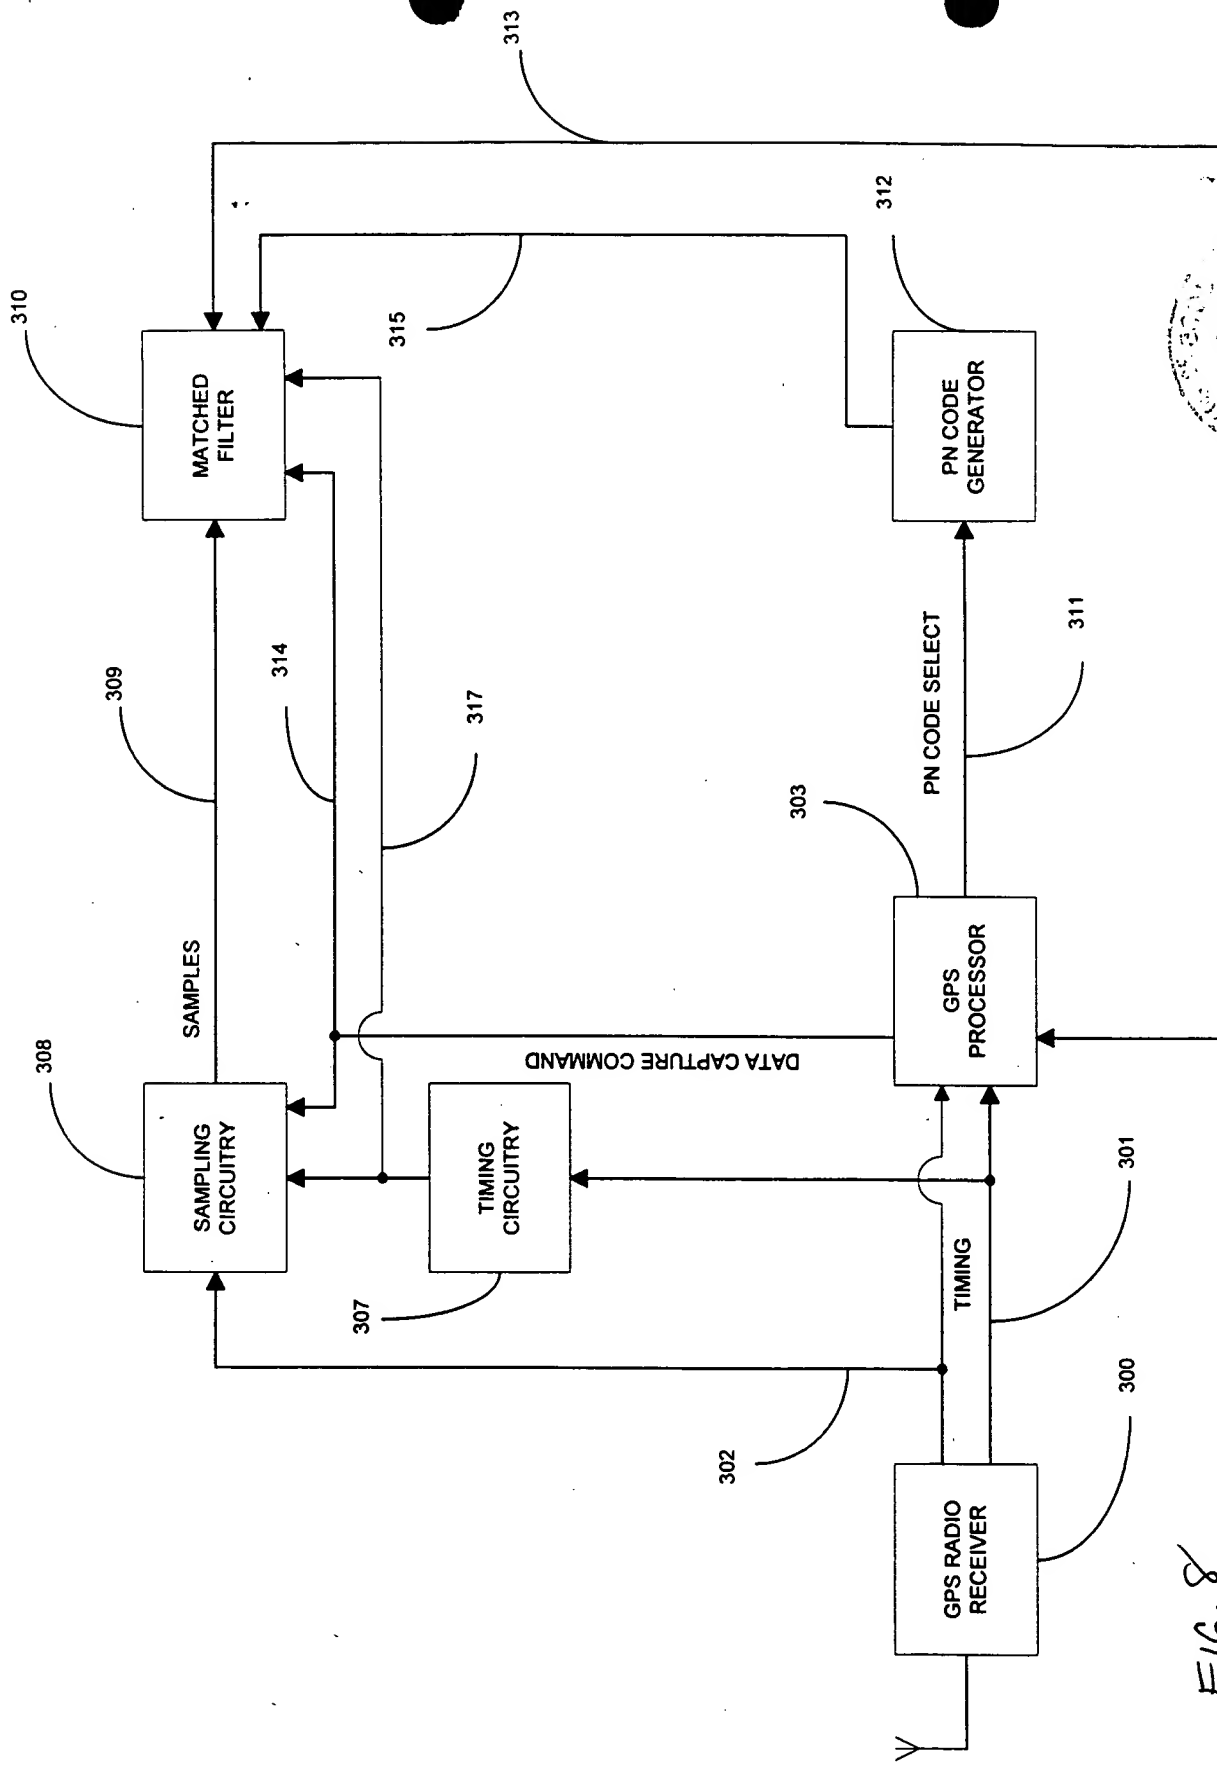


FIG. 8
FIGURE 8


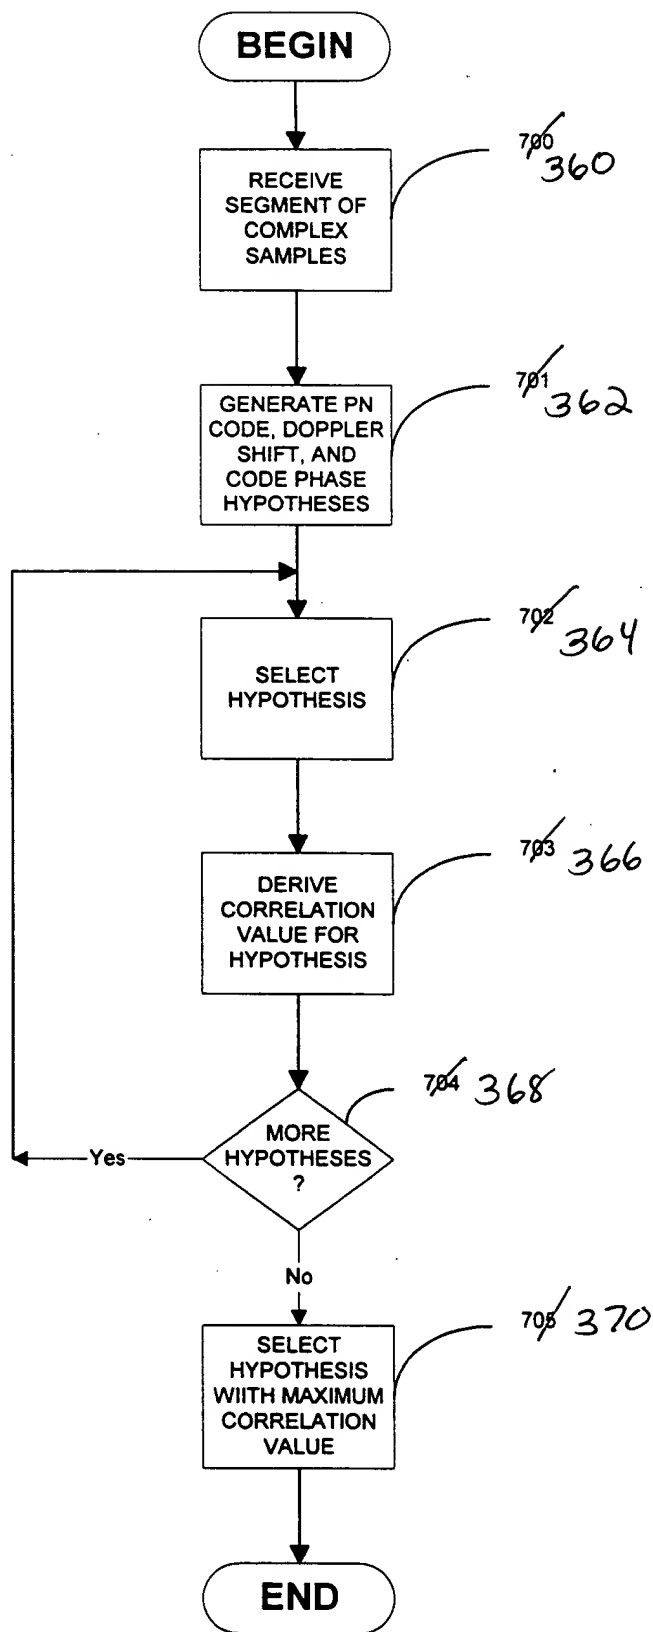


FIG. 9
~~FIGURE 10~~

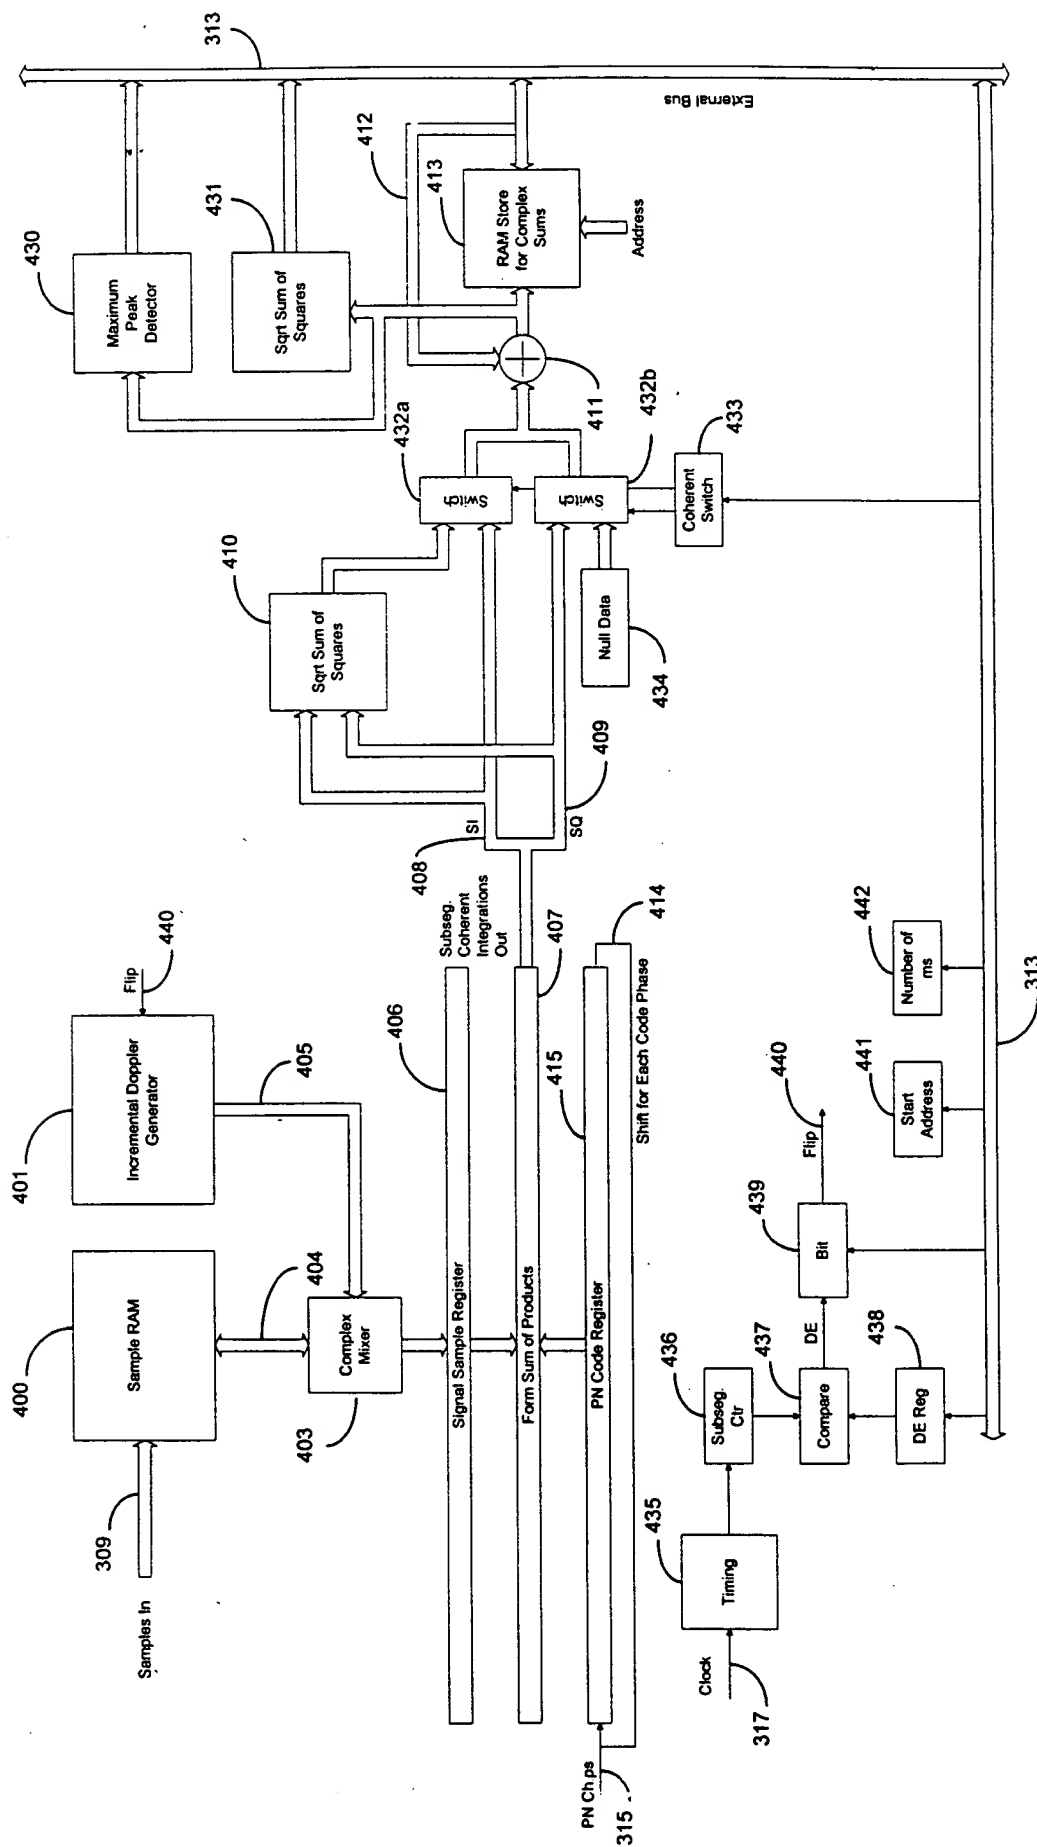

~~FIGURE 9-~~
FIG. 10

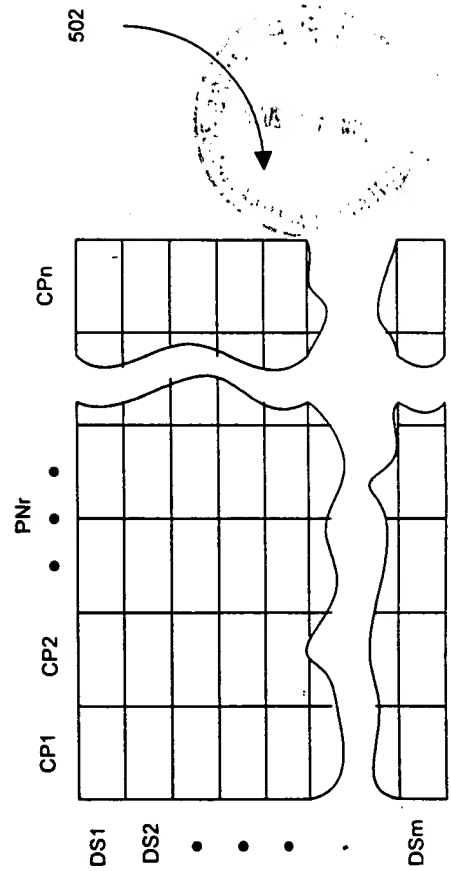
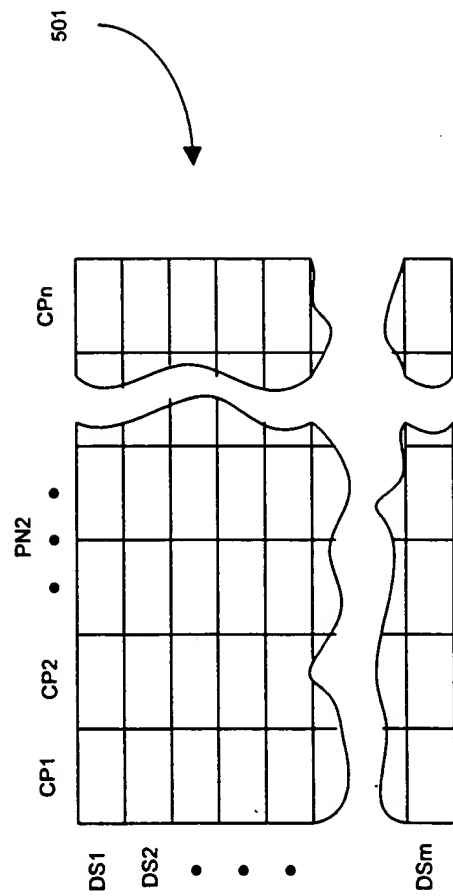
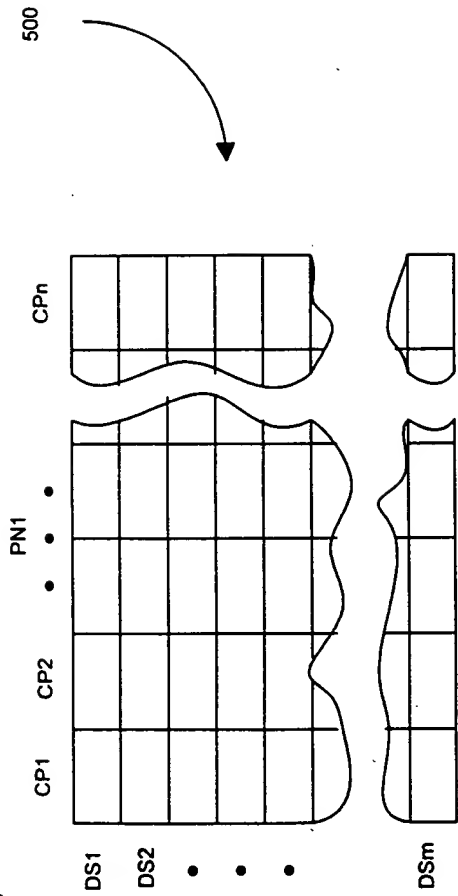


FIG. 11
FIGURE 11-

ACCUMULATED

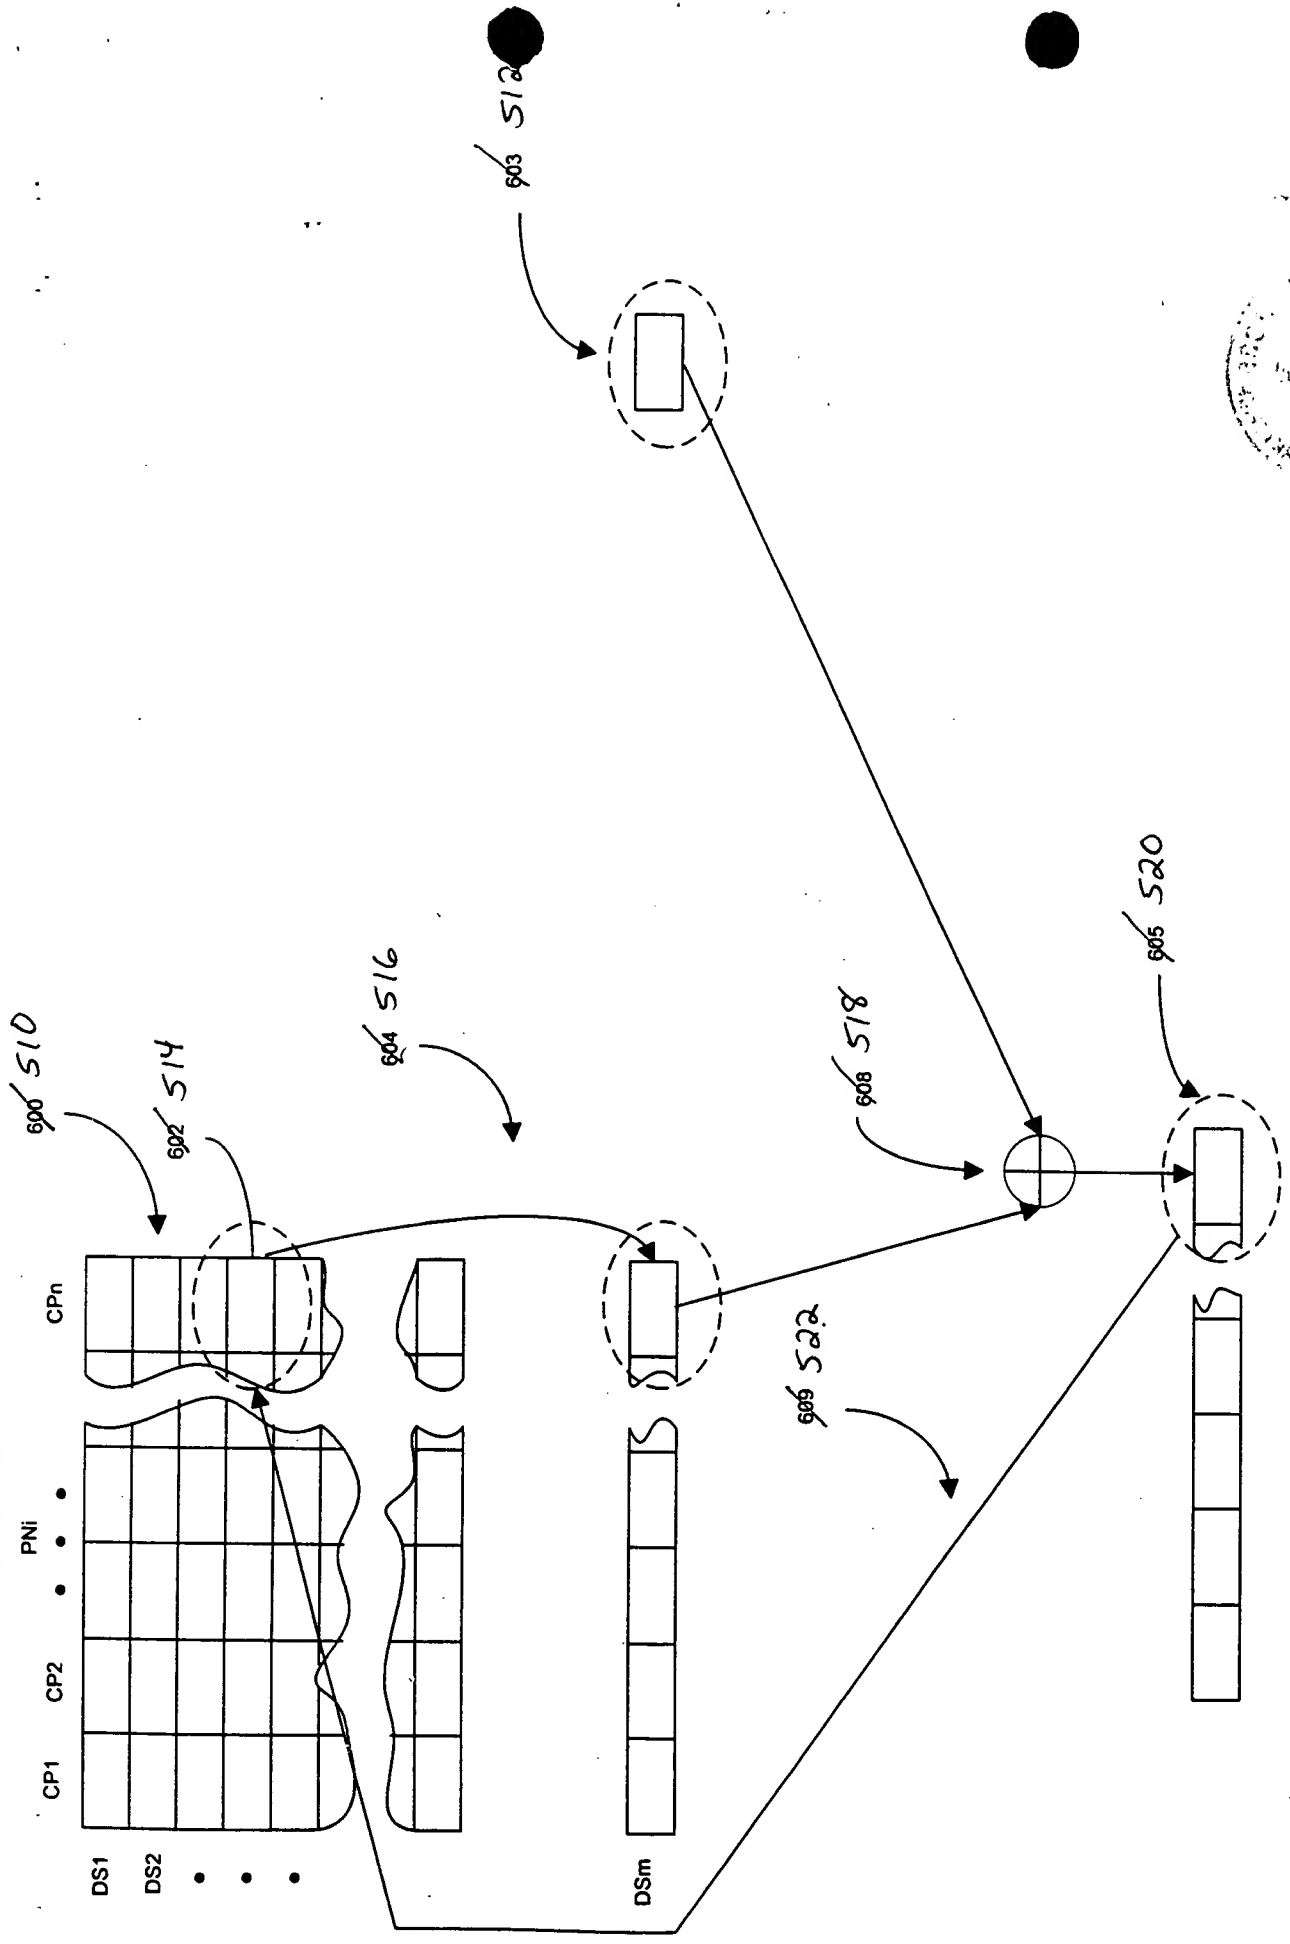
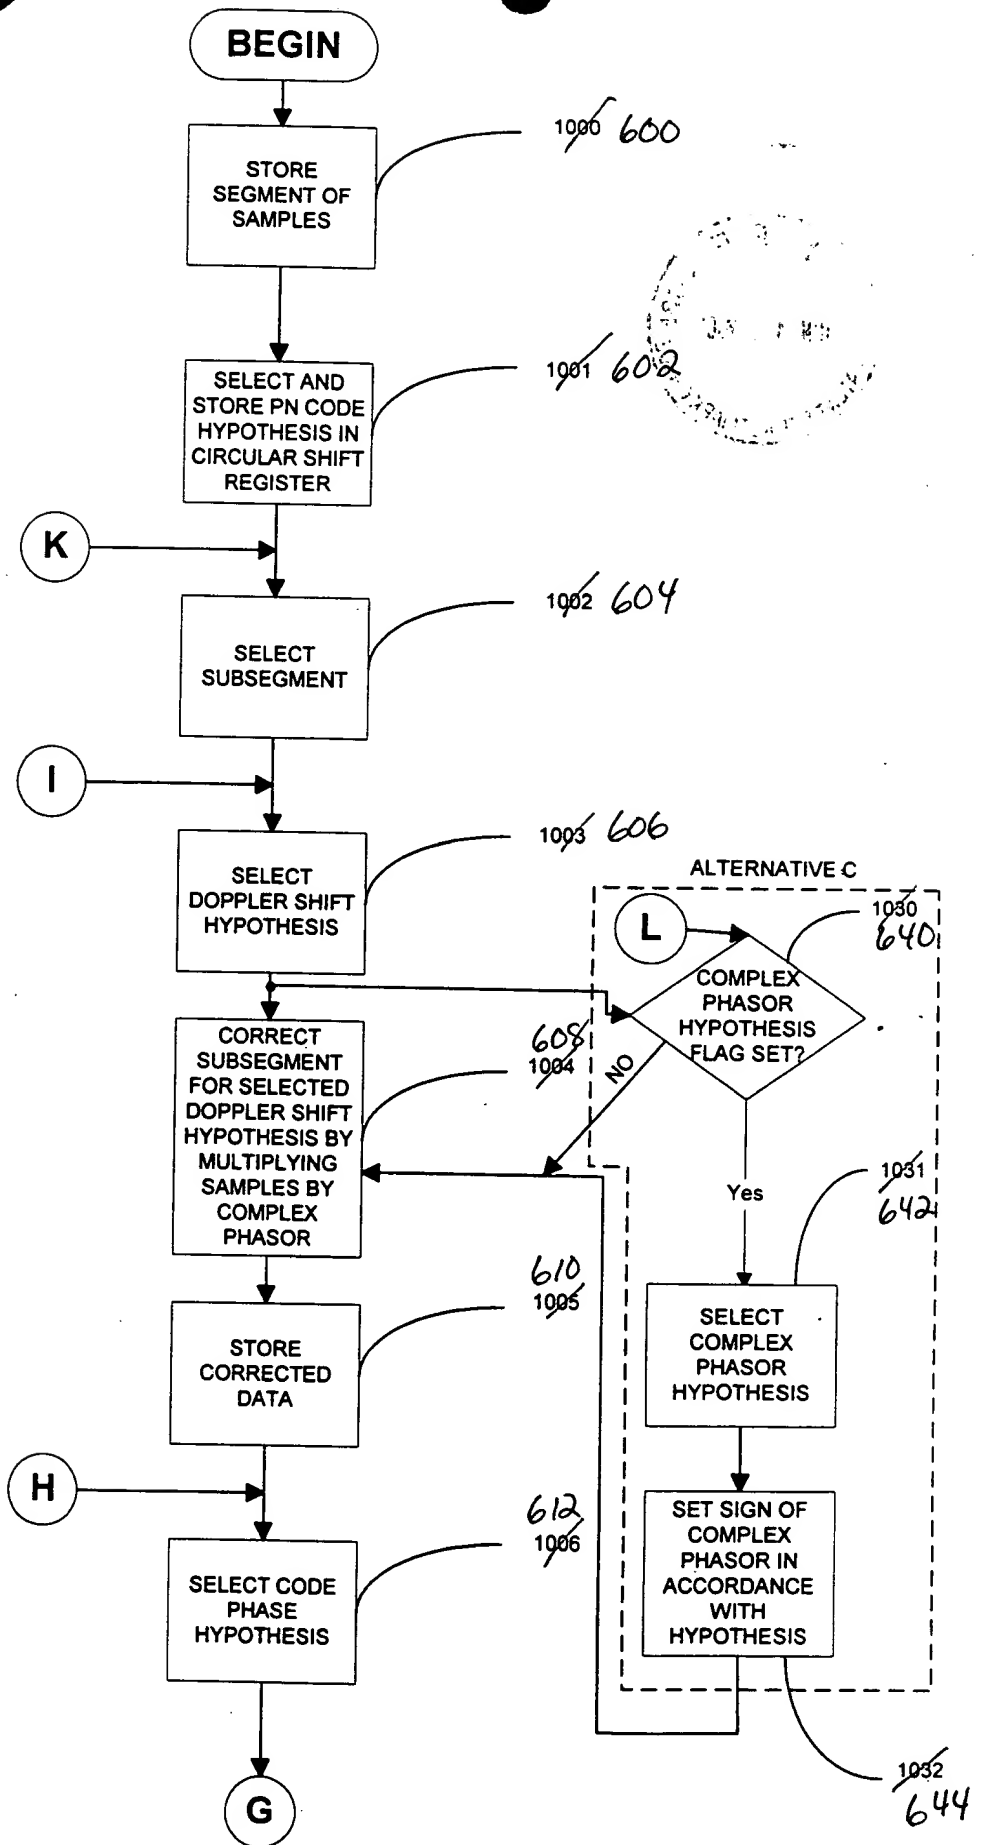


FIG. 12
FIGURE 12



FIG. 13A
FIGURE 13A

13A
13B
13C



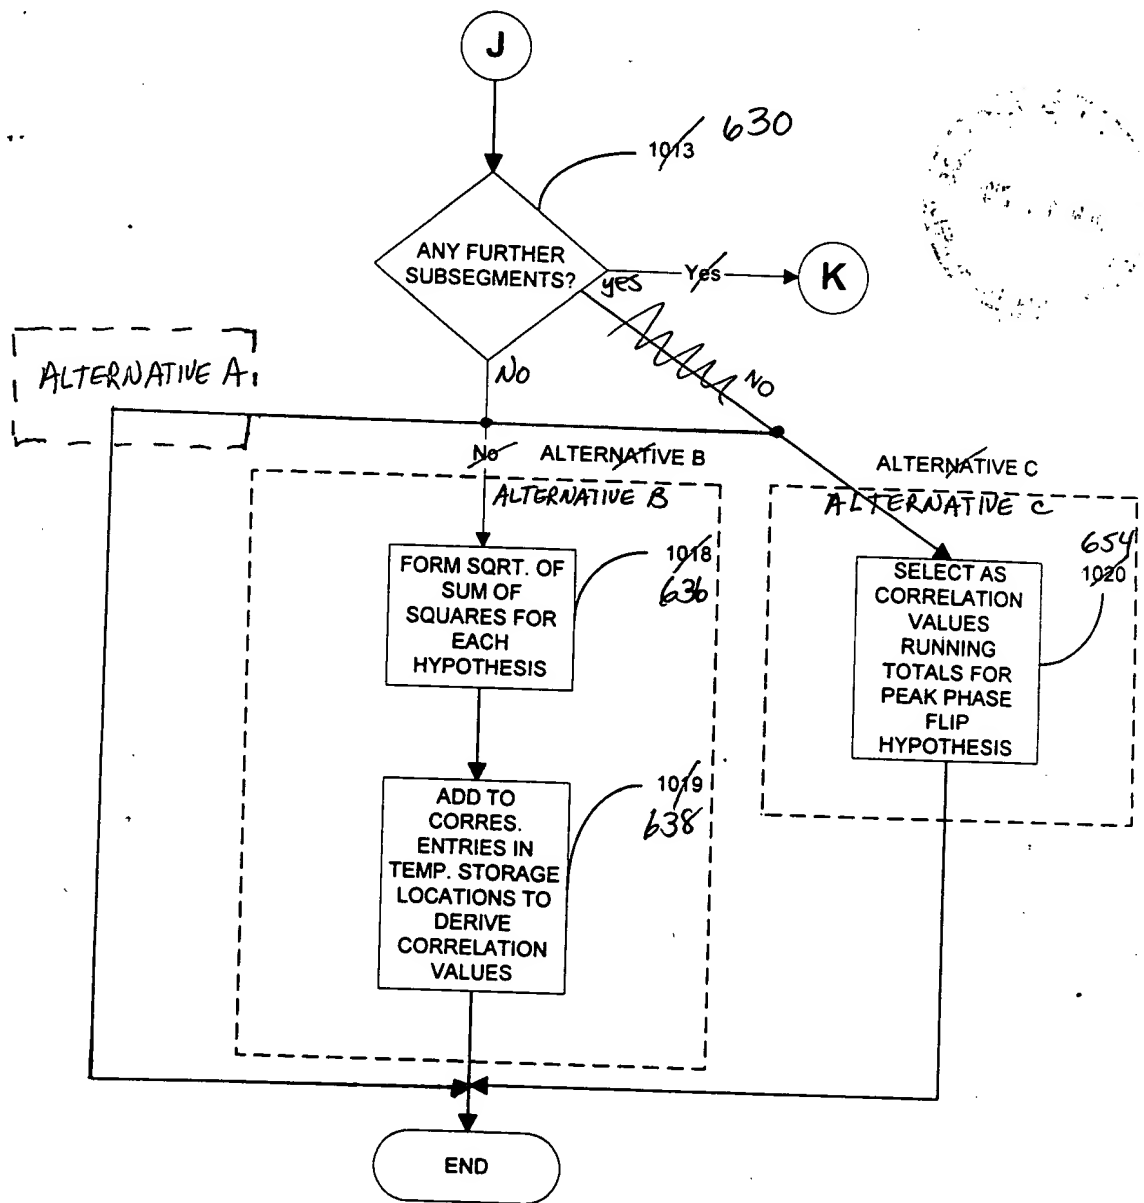


FIG. 13C
 FIGURE 13C

13A
13B
13C